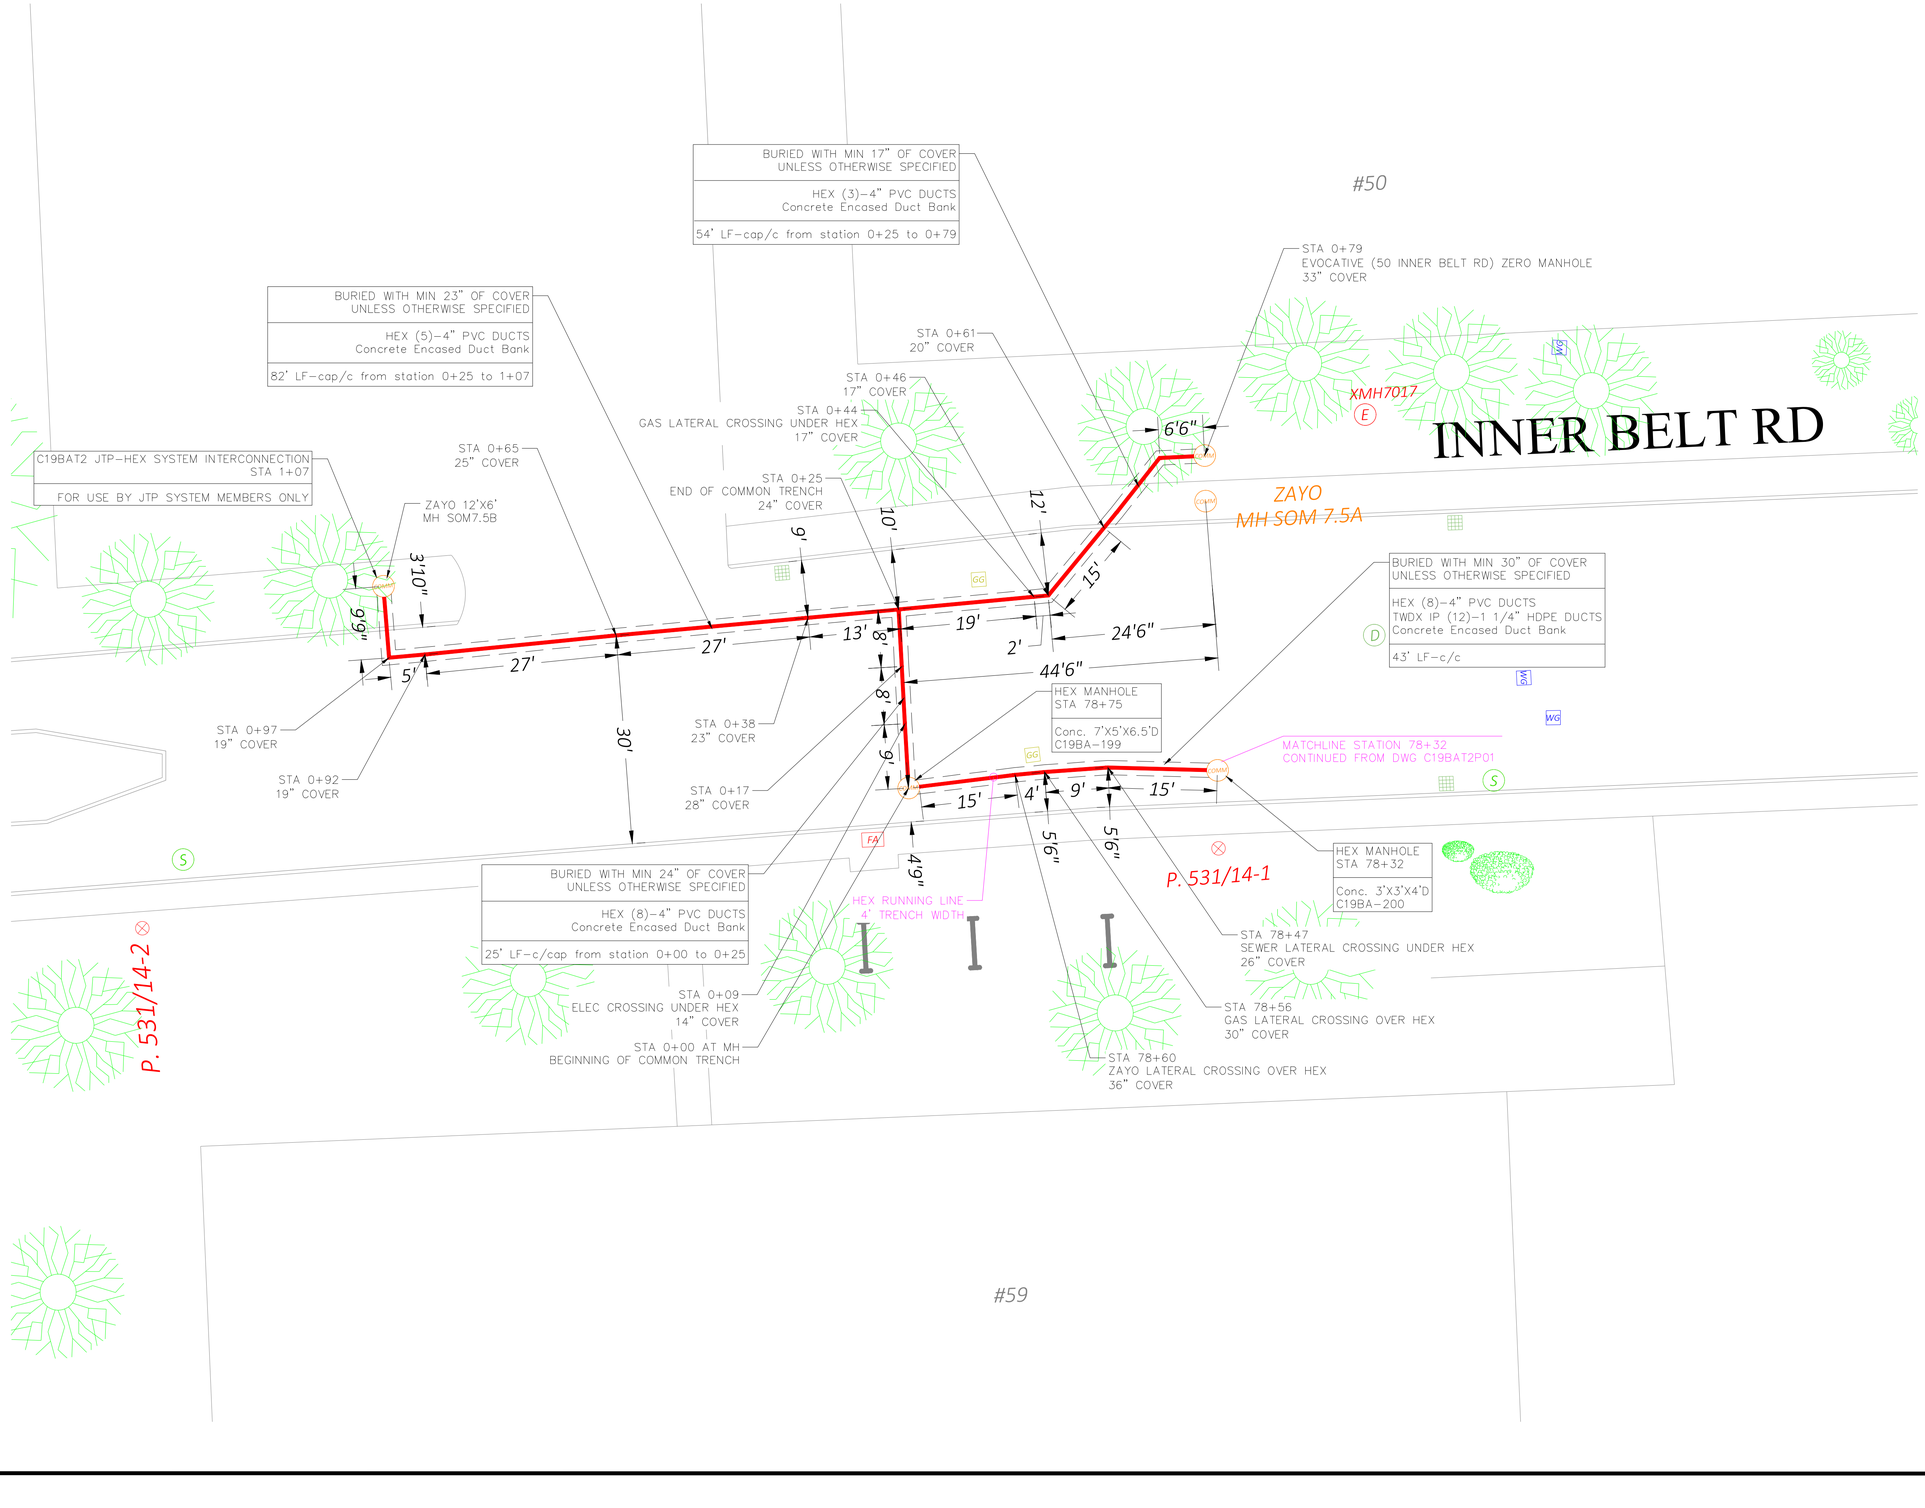

N

1"= 10 FEET
0 5 10 20 30

LEGEND

	ELECTRIC POLE		STREET LIGHT
	JOINT UTILITY POLE	E	ELECTRIC HH
	LAMP POST	T	TEL HH
	TRAFFIC LIGHT	C	CATV HH
S	SEWER MH		COMM PEDESTAL
D	DRAIN MH	IRR	IRRIGATION VALVE
T	TELEPHONE MH	WM	WATER METER
E	ELECTRIC MH	GM	GAS METER
CATV	CATV MH	SG	SEWER GATE
W	WATER MH	G	GAS GATE
	PAG	WG	WATER GATE
	BUSH/SHRUB		HYDRANT
R/W	RIGHT OF WAY	MB	MAIL BOX
	CULVERT		STONE BOUND
	GUARD RAIL		PARKING METER(S)
	FENCE		STEEL POST
ELEC VAULT	ELECTRIC VAULT		SIGN POLE
TRAF HH	TRAFFIC HH		UG CABLE MARKER
	PROPOSED HH		TRANSFORMER
	PROPOSED CONDUIT		CATCH BASIN

NOTE:
EXISTING UTILITIES SHOWN ARE APPROXIMATE AND NOT WARRANTED TO BE CORRECT. THE CONTRACTOR SHALL VERIFY THE LOCATION OF ALL PUBLIC AND PRIVATE UTILITIES PRIOR TO BEGINNING ANY EXCAVATION.

CALL BEFORE YOU DIG
UNDERGROUND SERVICE ALERT
72 HOURS NOTICE REQUIRED.
ENTER 1-888-DIG-SAFE

PREPARED BY:
AXIS ENGINEERING GROUP

PREPARED FOR:
twdx Infrastructure

REV #	DESCRIPTION	DATE
GK-1	Upd. matchline to C19BA transmission	7/5/2024

TITLE:

HEX CONDUIT SYSTEM C19BA Tranche 2 CP1

50-59 INNER BELT RD
SOMERVILLE, MA

SURVEYED BY: AXIS ENGINEERING	PRINT NO: 1 OF 1
DRAWN BY: MB	SCALE: 1" = 10'
DATE: 5/19/2023	SHEET SIZE: D (36" X 24")

07/5/2024 X:\JP Planning\Build\Xernos (HEX) Program\As Built System Diagrams\C19BAT2\P1\C19BAT2CP1P01.dwg